


## 30 Yingli 230 Watt YL230P-29b Modules

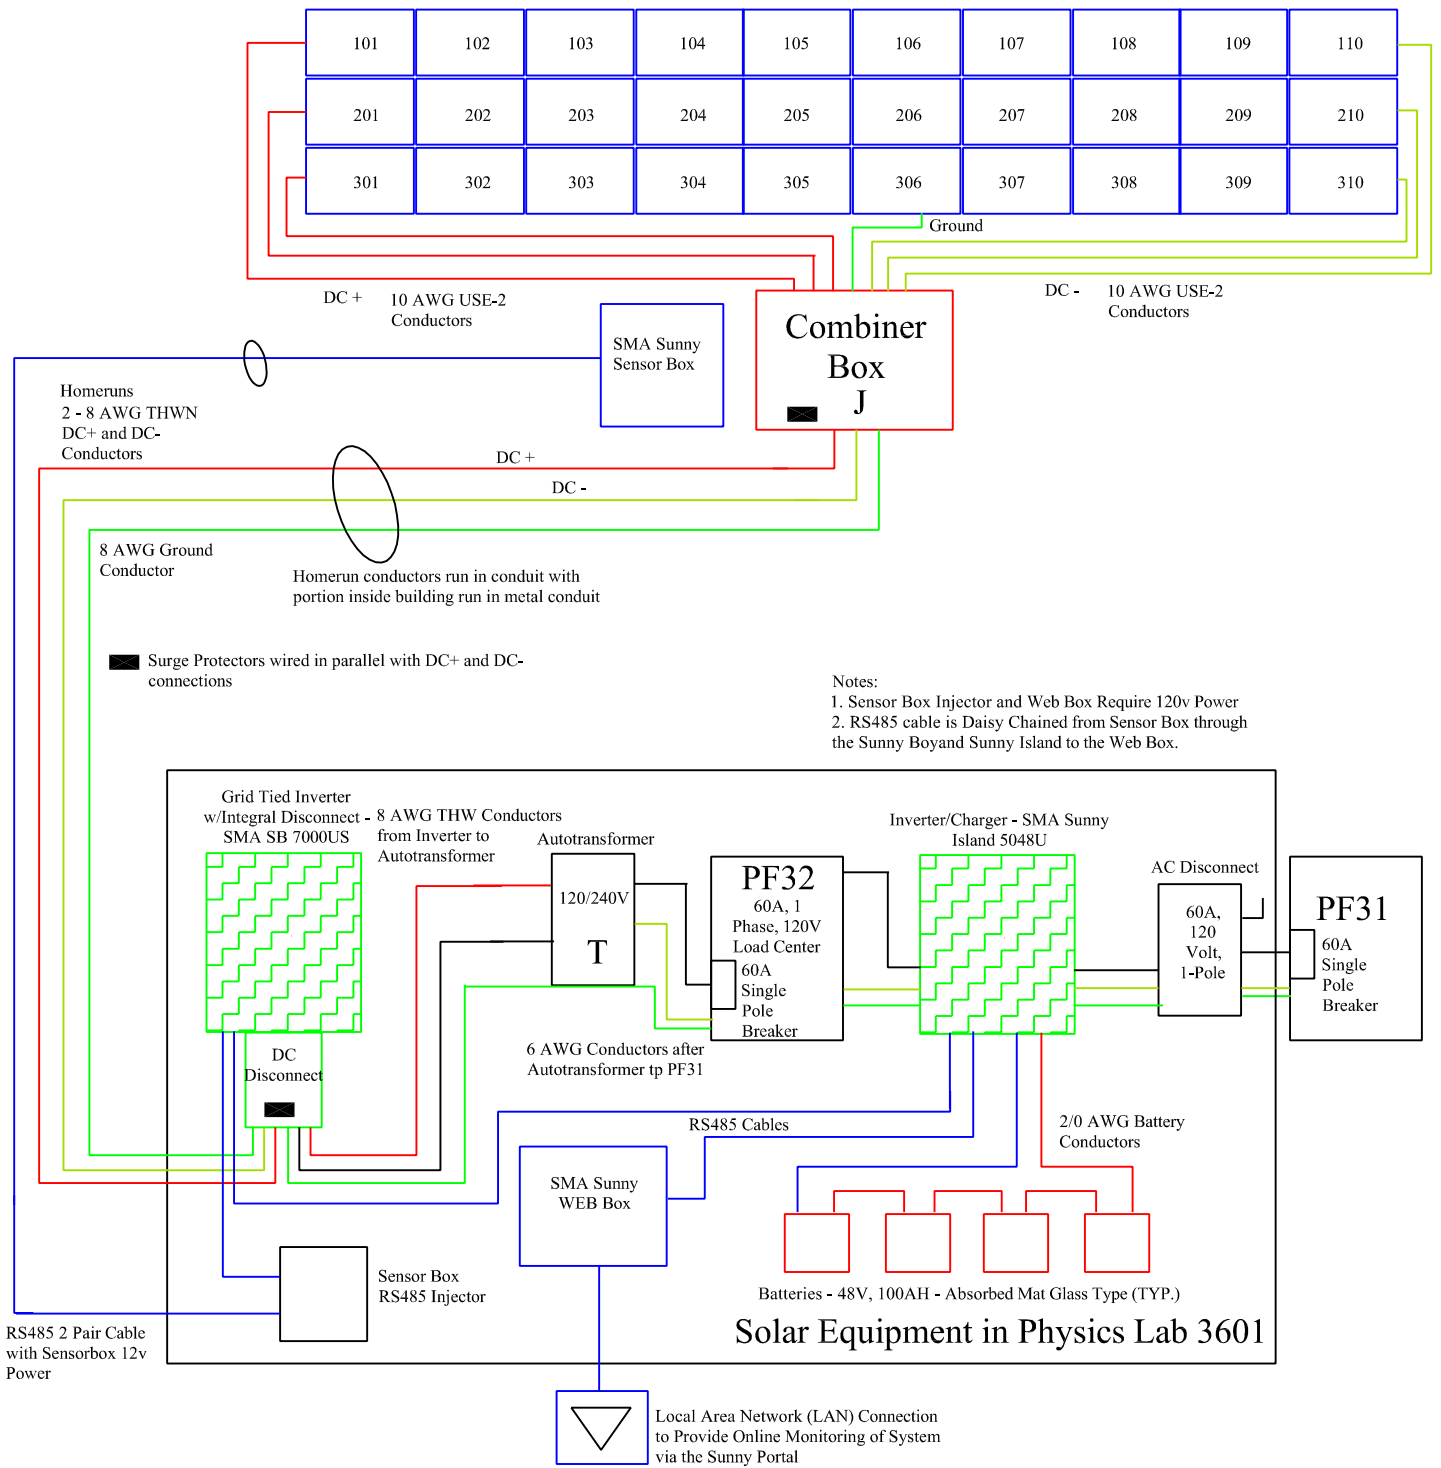

# Maine Solar Engineering

**Hampden Academy 6.9 KW  
PV System As Built**

November 2010

Rich Roughgarden  
 PO Box 57  
 Palermo, ME 04354  
 207-993-2632  
 rroughga@fairpoint.net